



LIST OF DRAWINGS			
DHEMAJI GNM			
Sl No.	Drawing Name	Drawing Number	No
1	AS BUILT SITE PLAN	2024/ASSIST-GNM/DHE/SP/AS BUILT/01	1
2	PROPOSED SITE PLAN	2024/ASSIST-GNM/DHE/SP/PROP/01	1
	CIVIL		
3	AS BUILT GROUND FLOOR PLAN FOR ACADEMIC BLOCK	2024/ASSIST-GNM/DHE/AR/ACA/AS BUILT/01	1
4	AS BUILT GROUND FLOOR PLAN FOR HOSTEL BLOCK	2024/ASSIST-GNM/DHE/AR/H/PROP/01	1
5	PROPOSED GROUND FLOOR PLAN FOR ACADEMIC BLOCK	2024/ASSIST-GNM/DHE/AR/ACA/PROP/01	1
6	PROPOSED GROUND FLOOR PLAN FOR ACADEMIC BLOCK 1	2024/ASSIST-GNM/DHE/AR/ACA/PROP/01	1
7	PROPOSED FIRST FLOOR PLAN FOR ACADEMIC BLOCK 1	2024/ASSIST-GNM/DHE/AR/ACA/PROP/02	1
	PLUMBING		
8	PLUMBING LAYOUT FOR GROUND FLOOR PLAN ACADEMIC BLOCK	2024/ASSIST-GNM/DHE/P/ACA/PROP/01	1
9	PLUMBING LAYOUT FOR GROUND FLOOR PLAN HOSTEL BLOCK	2024/ASSIST-GNM/DHE/P/H/PROP/01	1
	ELECTRICAL		
10	ELECTRICAL LAYOUT FOR GROUND FLOOR PLAN ACADEMIC BLOCK	2024/ASSIST-GNM/DHE/E/ACA/PROP/01	1
11	ELECTRICAL LAYOUT FOR GROUND FLOOR PLAN HOSTEL BLOCK	2024/ASSIST-GNM/DHE/E/H/PROP/01	1
	FIRE FIGHTING		
12	FIRE FIGHTING LAYOUT OF AS BUILT GROUND FLOOR PLAN ACADEMIC BLOCK	2024/ASSIST-GNM/DHE/FF/ACA/PROP/01	1
13	FIRE FIGHTING LAYOUT OF AS BUILT GROUND FLOOR PLAN HOSTEL BLOCK	2024/ASSIST-GNM/DHE/FF/H/PROP/01	1
14	ROAD DETAIL	2024/ASSIST-GNM/DHE/ROAD /01	1
15	DRAIN DETAIL	2024/ASSIST-GNM/DHE/DRAIN/01	1
16	SECURITY CABIN	2024/ASSIST-GNM/DHE/SECURITY /01	1
17	SEPTIC TANK	2024/ASSIST-GNM/DHE/SEPTIC TANK /01	1

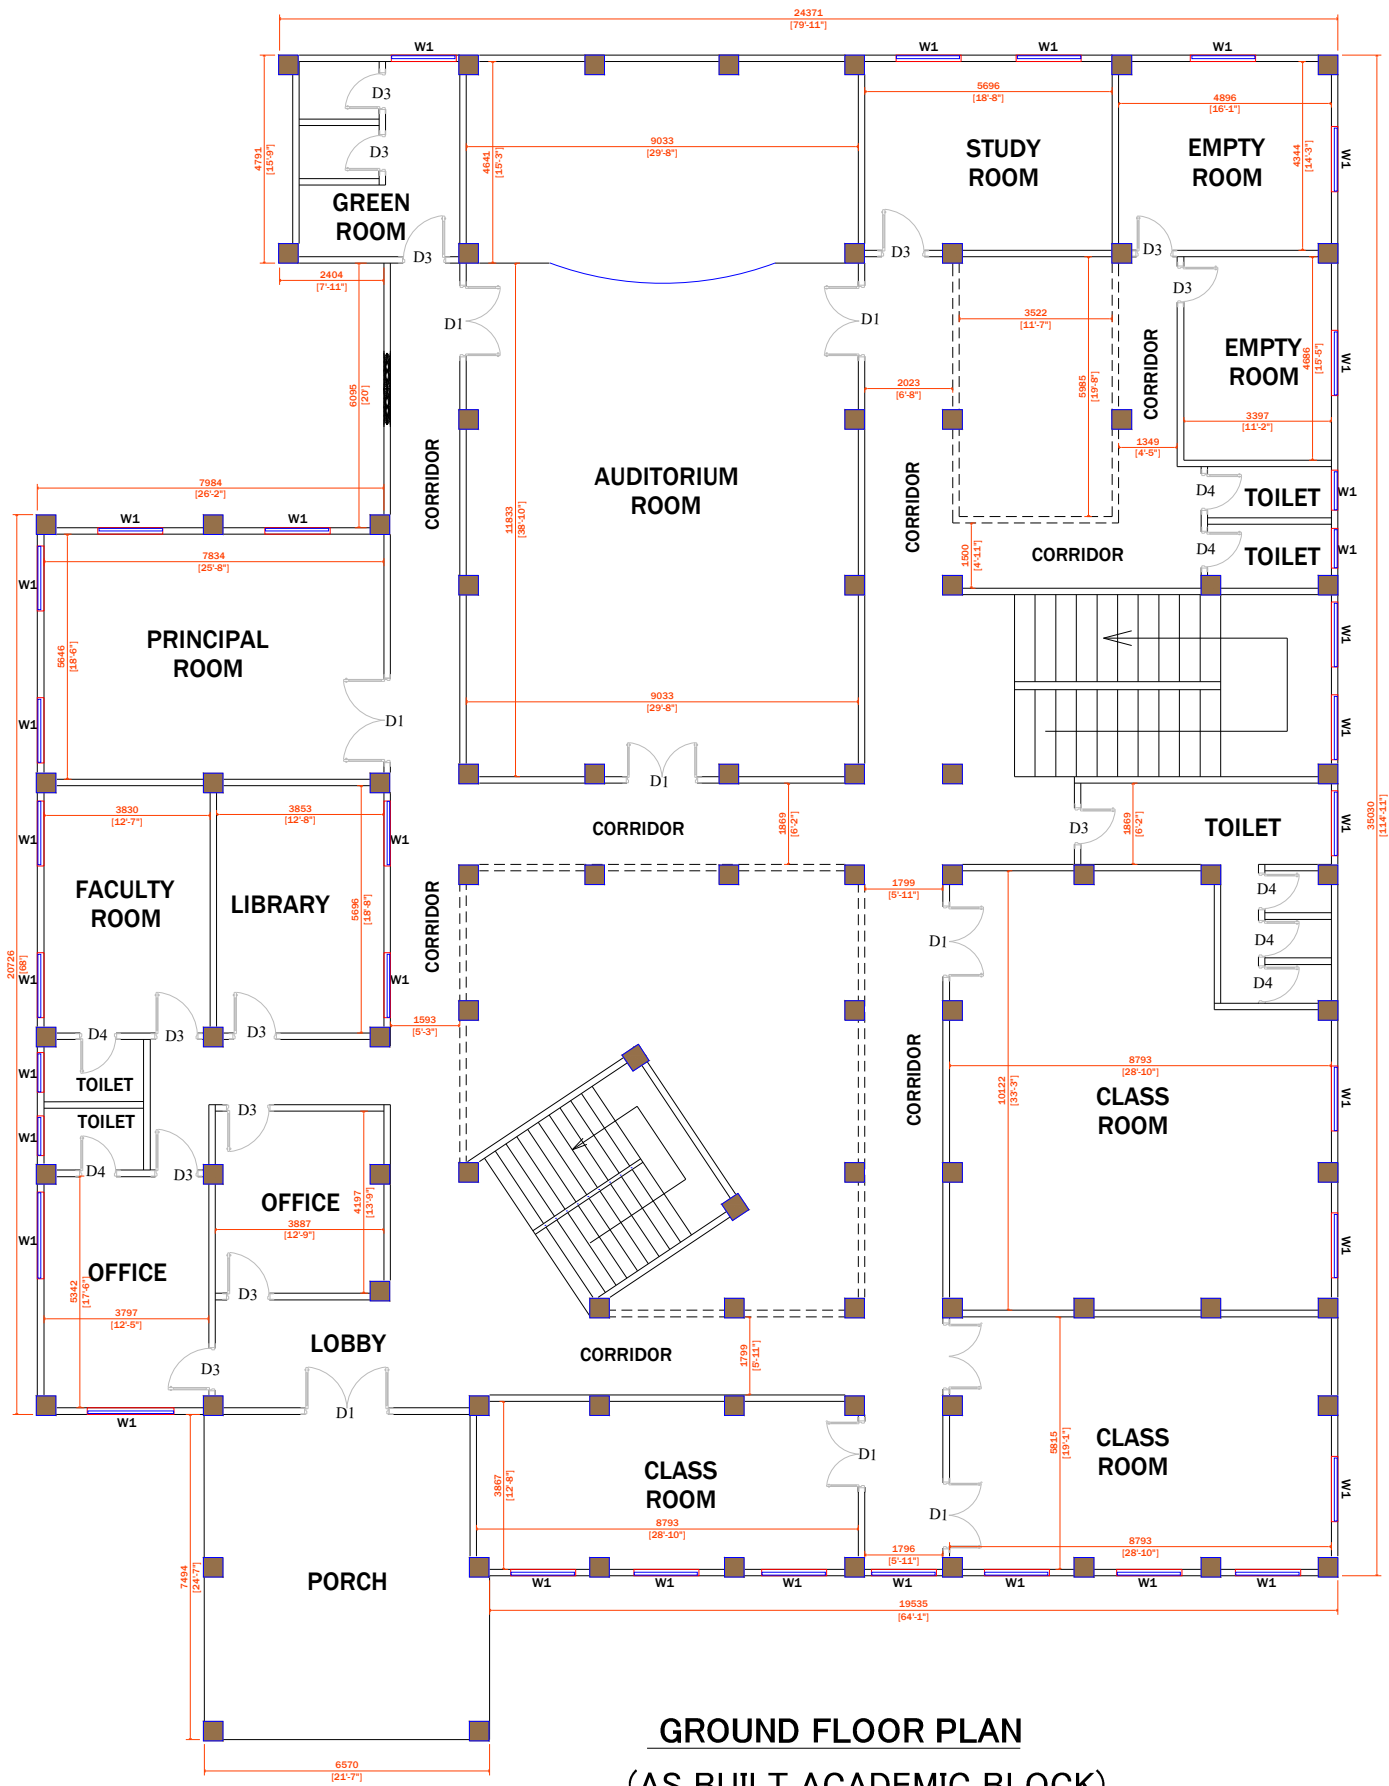

GROUND FLOOR PLAN
(AS BUILT ACADEMIC BLOCK)

PROJECT:- ASSAM STATE SECONDARY HEALTHCARE INITIATIVE FOR SERVICE DELIVERY TRANSFORMATION (ASSIST)		
CLIENT:- ASSAM HEALTH INFRASTRUCTURE DEVELOPMENT & MANAGEMENT SOCIETY (AHIDMS)		
PRINCIPAL CONSULTANT:  INTEGRA VENTURES HEALTHCARE INFRASTRUCTURE CONSULTANCY <		

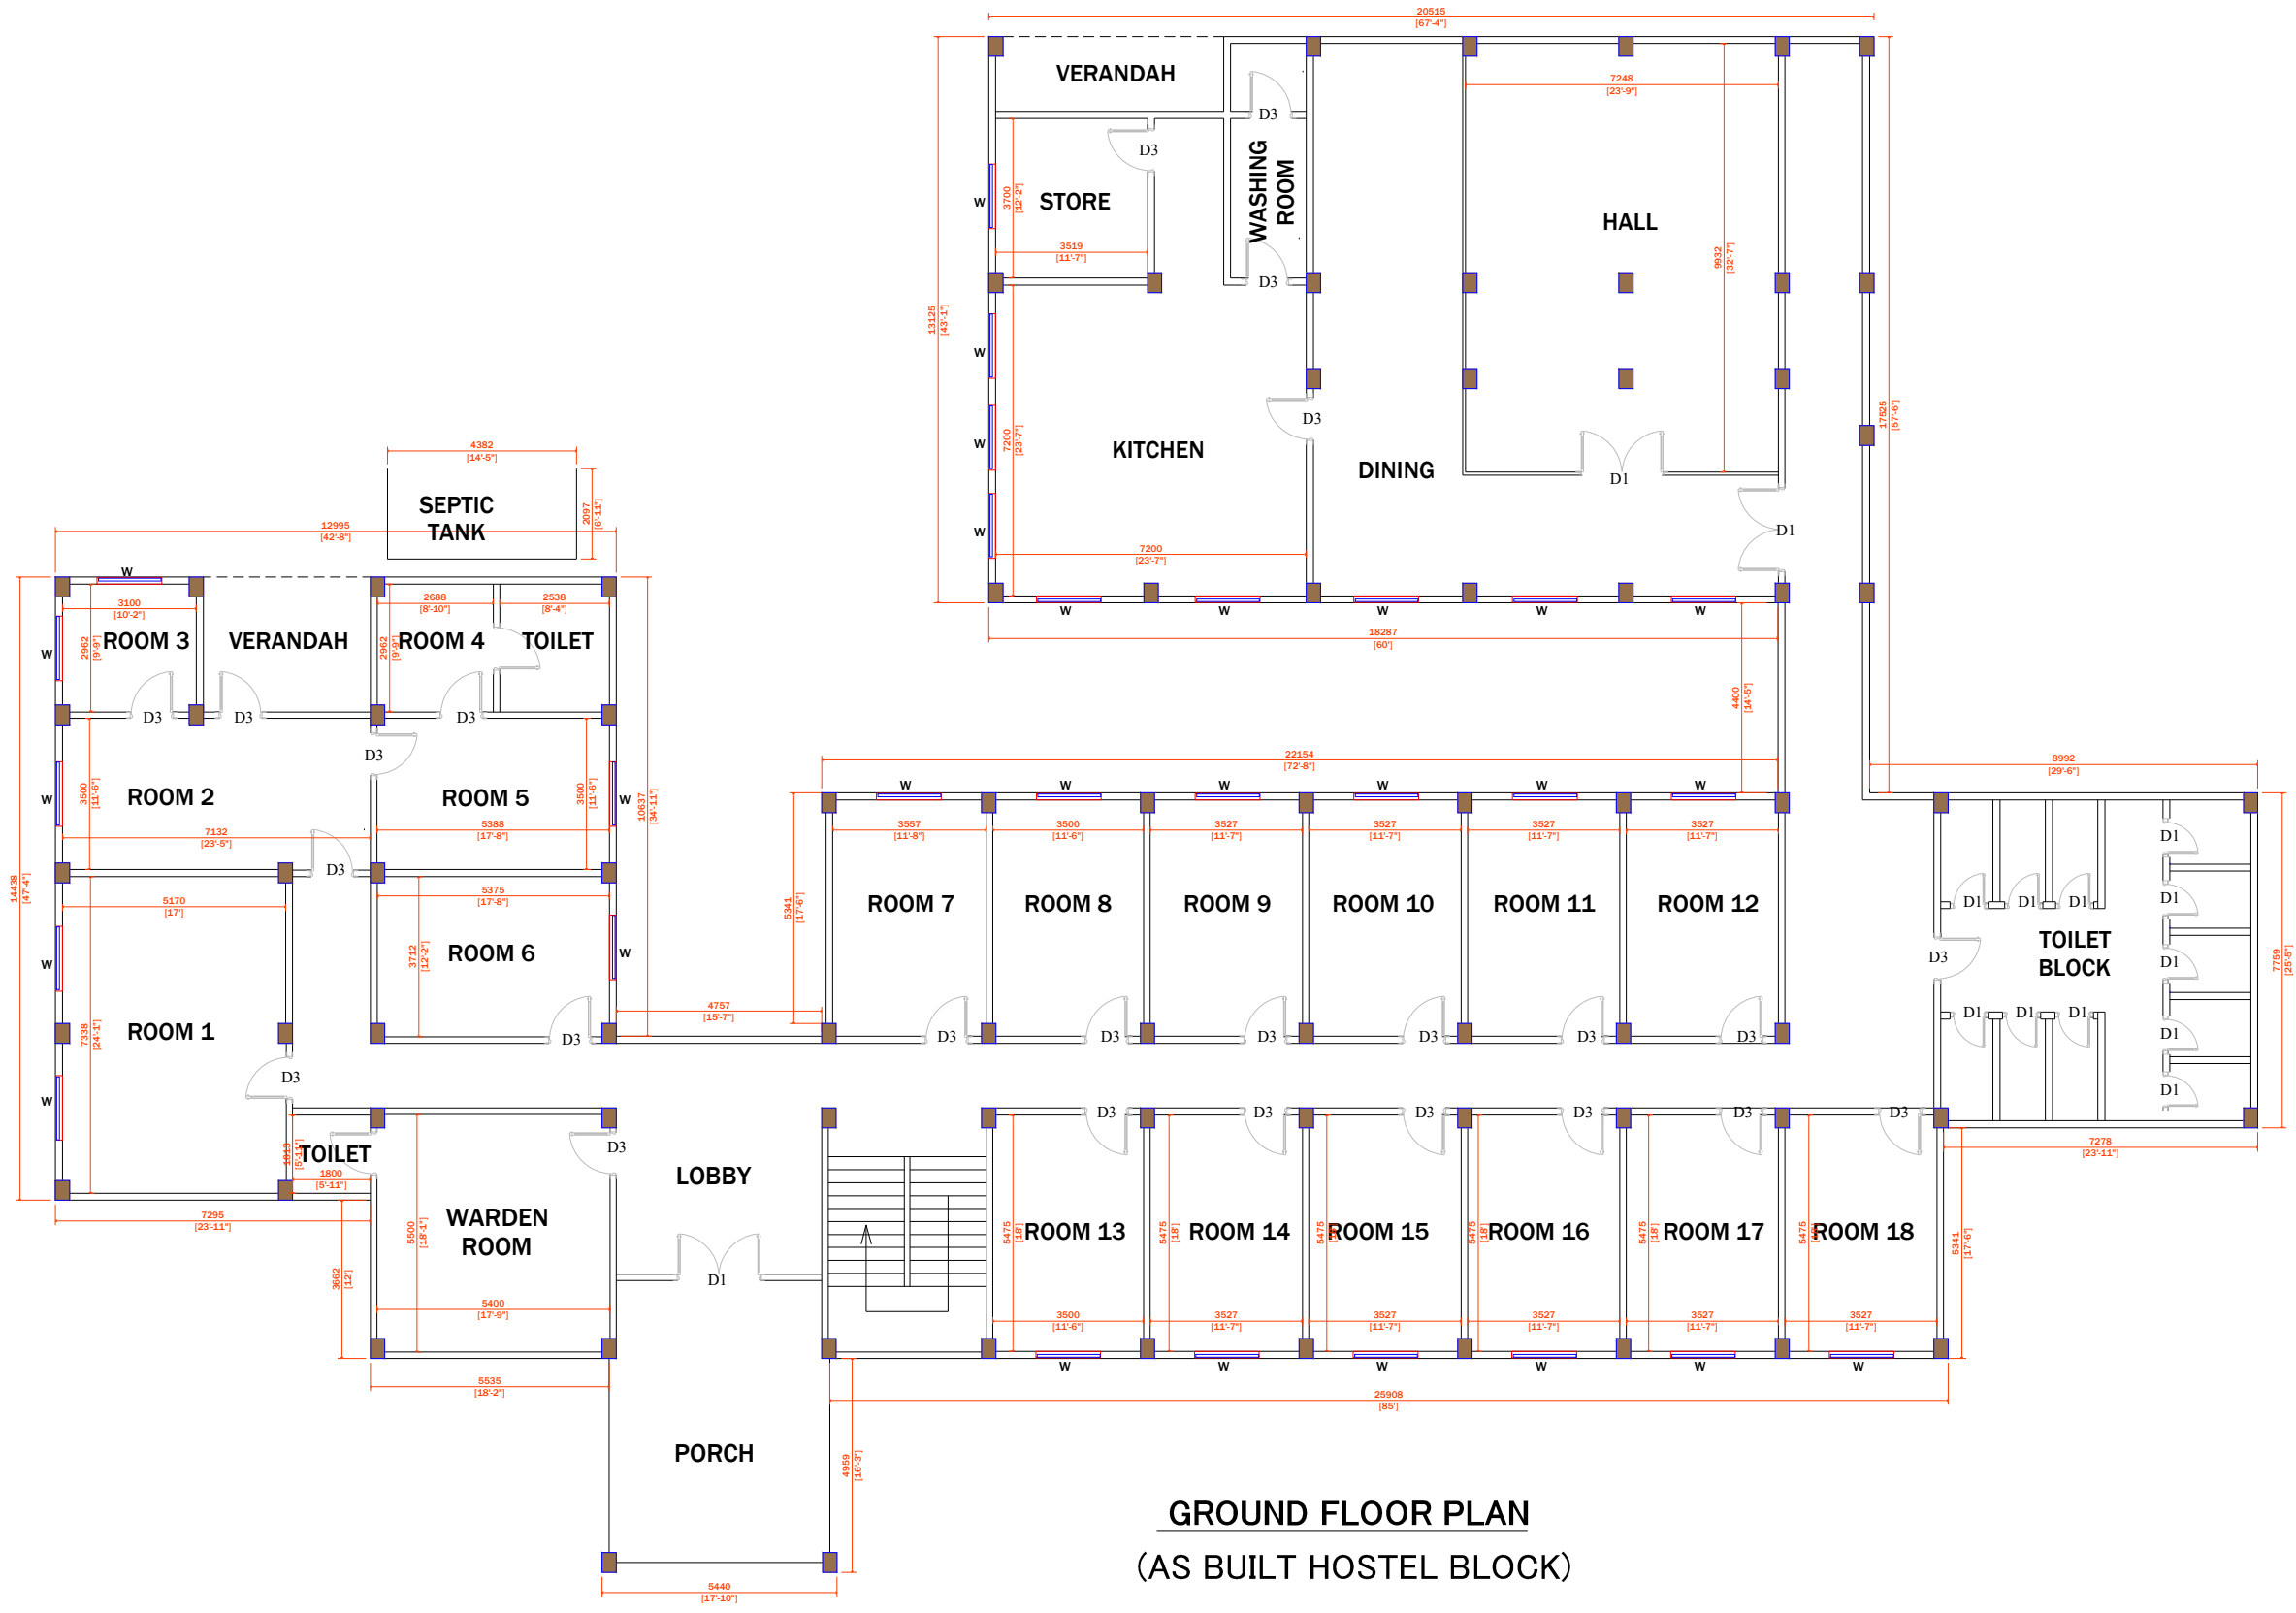

GROUND FLOOR PLAN
(AS BUILT HOSTEL BLOCK)

PROJECT:-
ASSAM STATE SECONDARY HEALTHCARE
INITIATIVE FOR SERVICE DELIVERY
TRANSFORMATION (ASSIST)

CLIENT:-
ASSAM HEALTH INFRASTRUCTURE
DEVELOPMENT & MANAGEMENT SOCIETY
(AHIDMS)

PRINCIPAL CONSULTANT:
**INTEGRA VENTURES**
HEALTHCARE INFRASTRUCTURE CONSULTANCY
PRIVILEGE
PRITHVI GREENS, BLOCK A GROUND FLOOR
PATHARQUARY GUWAHATI-781171, ASSAM
M: +91-9401727143

STAGE:- DPR

DRAWING NO:-
2024/ASSIST-GNM/DHE/AR/HS/AS BUILT/01

START DATE	ISSUE DATE	SHEET SIZE
	07-04-2025	A3

PROJECT CODE:- 2024/ASSIST-GNM/DHE

SCALE:- N.T.S.

DRAWING TITLE:-
AS BUILT GROUND FLOOR PLAN
FOR HOSTEL BLOCK,
GNM DHEMAJI,ASSAM

